

LANE COUNTY RESTORED CORNER

Index 2527

Corner West one-quarter corner section 12

Twp. 22 S R. 4 WEST

From original G. L. O. field notes, dated 1855

Corner Post

Witness 60" Fir North 4° West 27 links

Marks 50" Cedar North 85° East 36 links

From reestablishment field notes, dated \_\_\_\_\_

Corner \_\_\_\_\_

Witness \_\_\_\_\_

Marks \_\_\_\_\_


EVIDENCE FOUND: August 2, 19 60

No trace

60" Fir snag old axe marks

50" Cedar shell

EVIDENCE FOUND: \_\_\_\_\_, 19 \_\_\_\_\_

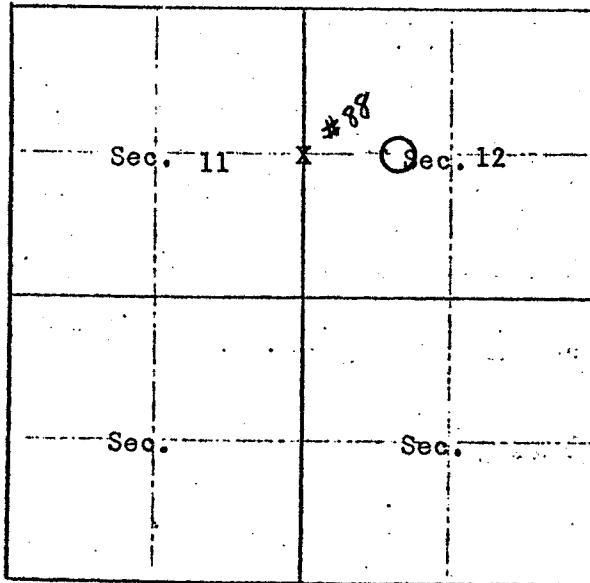

RETRACEMENT NOTES: Set 1" Alum pipe set by dist. and bearing from  
remains of Orig. B.T.'s Plates, "W" nails, 20° Declination

10" Fir South 83° East 14.0 feet

8" Fir South 46° West 8.0 feet

Glen McChesney  
 Signature

Oct. 12, 1960  
 Date

Land Agent  
 Title

CS 53/1-55