

LANE COUNTY RESTORED CORNER

Index 2581

Corner East one-quarter corner Section 2

Twp. 22 S R. 4 WEST

From original G. L. O. field notes, dated 1855

EVIDENCE FOUND: September 26, 19 60

Corner Post

Gone

Witness 8" Fir South 85° East 77 links

Now 26" x 6' stump scribing visible

Marks 6" Fir South 63° West 46 links

Down 22" Fir - scribing visible

From reestablishment field notes, dated 1958 W. Co.

EVIDENCE FOUND: Sept. 26, 19 60

Corner 1/2" steel rod

Found

26" Fir South 78° East 50.0 feet

Now a stump

Witness 22" Fir South 78° West 29.6 feet


Down

Marks

RETRACEMENT NOTES:

Plate, "W" nail, 20° Declination

18" Fir South 31° West 39.8 feet

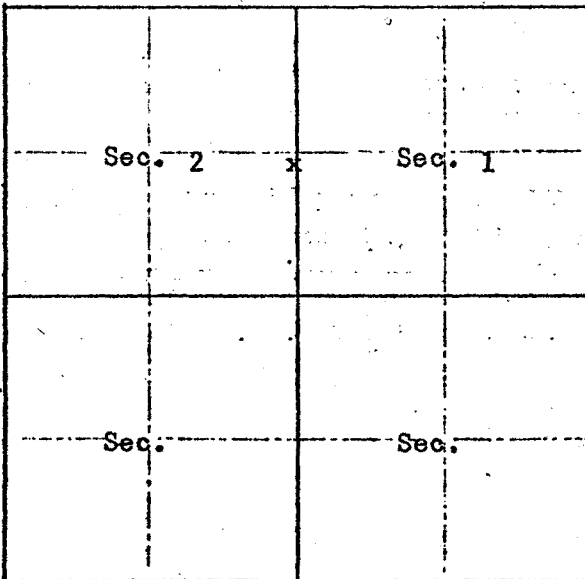

Glen McChesney

Signature

12/19/60

Date

Land Agent

Title

CS 53/1-57