

LANE COUNTY RESTORED CORNER

Index 2712

Corner South one-quarter corner Section 36

Twp. 21 S R. 4 WEST

From original G. L. O. field notes, dated _____

EVIDENCE FOUND: 9/25/61, 1961

Corner _____

4 X 4 Post 3.5 feet high

Witness _____

18" Fir bears South 35° West 21.2 feet

Marks _____

26" Fir bears North 32° East 12.6 feet

18" Fir bears North 73° West 17.2 feet

Scars, cruisers marks & BLM and Weyer tags.

From reestablishment field notes, dated _____


EVIDENCE FOUND: _____, 19____

Corner _____

~~RkxkxxxxErxkCFDGx28Bx16~~

Witness _____

Marks _____

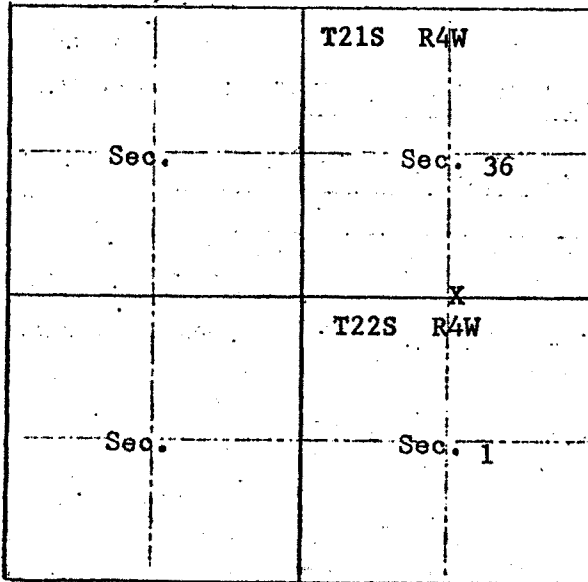

RETRACEMENT NOTES: _____

Photo E-R-CFDG 28 B-16

R. A. Hohenhaus

Signature

9/25/61

Date

Timber Appraiser

Title

CS 53/1-59