

Corner Section 14, and 23

T 22S

R 4W

From G.L.O. Notes dated: _____

Evidence Found: 9-19, 1962

Corner Fir tree-South 60° W. 25.7 ft.

Corner Snag dead-cut open & fnd. good scribe.

Incense Cedar North 8° W. 23.8 ft.

Good axe scar-tree alive.

Witness _____

Marks _____

Reestablishment Notes dated _____


Evidence Found: _____ 19

Corner _____

Corner _____

Witness _____

Marks _____

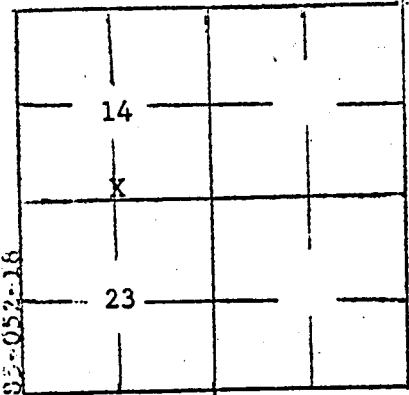

Restoration Notes: Cor. set IP with brass cap mkd: "Doug. Co. Surveyors Office", 1962 T22S R4W 1/2 Sec. 14, Sec. 23.

Blaze & scribe new trees:

14" Doug. Fir N66° W. 11.3 ft. mkd. 1/2 Sec. 14 DCS BT

14" Doug. Fir South 70° W. 51.5 ft. mkd. 1/2 Sec. 23 DCS BT.

A 1/2" Alum. pipe brs. South 66° E. 2.0 ft. from corner.

State Coordinates N= _____ S= _____
 9-19-62 Milo E. Godfrey Doug. Co. Surveyor's Office
 (Date) (Signature) (Title)
 (use back of card for diagram)

LANE COUNTY RESTORED CORNER

Corner Northwest Corner section 24

T 22 S

R 4 W

From G.L.O. Notes dated: 1855

Evidence Found: March 9, 1962

Corner Post

Corner Gone

8" Cedar N 88° E 37 lks

Rotted, burned remains of down cedar

Witness 20" Cedar S 8° E 66 lks

36" Cedar str., rotted interior

Marks 30" Cedar S 67° W 38 lks

Remains of down broken cedar

18" Cedar N 55° W 36 lks

40" hollow Cedar

Reestablishment Notes dated 1957

Evidence Found: March 9 1962

Corner Set pipe and referenced:

Corner Fnd. 3/4" Gal. Pipe and 1/2" metal

10" Hemlock N 5 1/2° E 38.0'

Found O.K. (pipe)

Witness 8" Hemlock S 76° E 40.5'

New stump

Marks 30" W. Fir S 70° W 38.9'

Down - plate not visible.

18" Cedar str. N 55° W 36.0'


Found O.K.

Restoration Notes:

Plates; "W" nails and 20° declination

62" Fir S 58° E 34.8'

12" Yew S 54° W 54.5'

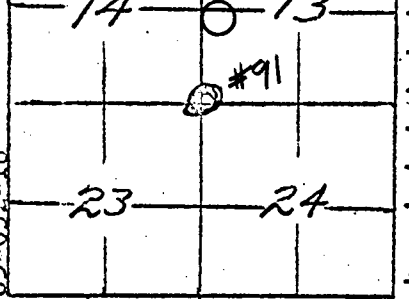

State Coordinates N= _____ S= _____
 7/19/62 Glen McChesney Land Agent
 (Date) (Signature) (Title)
 (use back of card for diagram)

CS 53/1-60