

LANE COUNTY RESTORED CORNER

Index 2227

Corner  $\frac{1}{4}$  Corner of Sections 2 & 11

Twp. 21 S R. 11 W

From original G. L. O. field notes, dated \_\_\_\_\_

EVIDENCE FOUND: \_\_\_\_\_, 19\_\_\_\_

Corner \_\_\_\_\_

Witness \_\_\_\_\_

Marks \_\_\_\_\_


From reestablishment field notes, dated Jan. 24, 1899

EVIDENCE FOUND: \_\_\_\_\_, 19\_\_\_\_

Corner In presence of D. Perini & Co. Surveyor, C. M. Collier, found only one stump of one Orig. B.T., part of letters still visible.

Witness \_\_\_\_\_

Marks \_\_\_\_\_

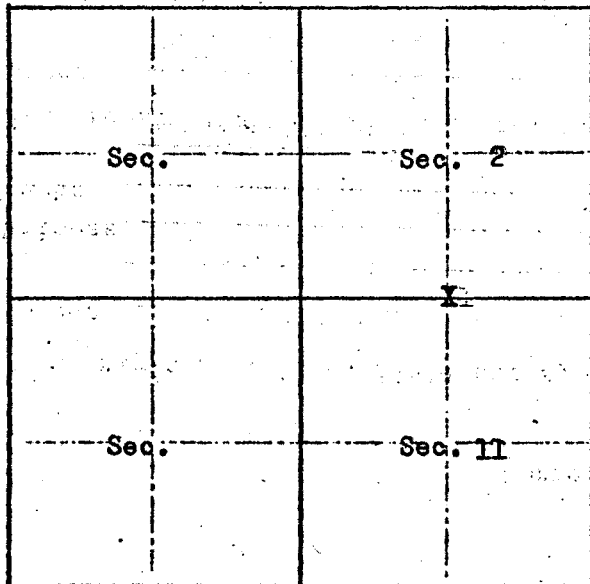

RETRACEMENT NOTES: Set a Cedar Post, from which:

20" Fir bears N.44°E. 25 lks.

12" Cedar " S.02°E. 32 lks.

Signature \_\_\_\_\_

Douglas County Surveyor's Office

Date \_\_\_\_\_

Title \_\_\_\_\_

CS 53/1-69