

LANE COUNTY RESTORED CORNER

Index 2229

Corner Corner common to Sections 11, 12, 13, 14

Twp. 21 S R. 4 W

From original G. L. O. field notes, dated \_\_\_\_\_

EVIDENCE FOUND: \_\_\_\_\_, 19\_\_\_\_

Corner \_\_\_\_\_

Witness \_\_\_\_\_

Marks \_\_\_\_\_


From reestablishment field notes, dated \_\_\_\_\_

EVIDENCE FOUND: \_\_\_\_\_, 19\_\_\_\_

Corner \_\_\_\_\_

Witness \_\_\_\_\_

Marks \_\_\_\_\_

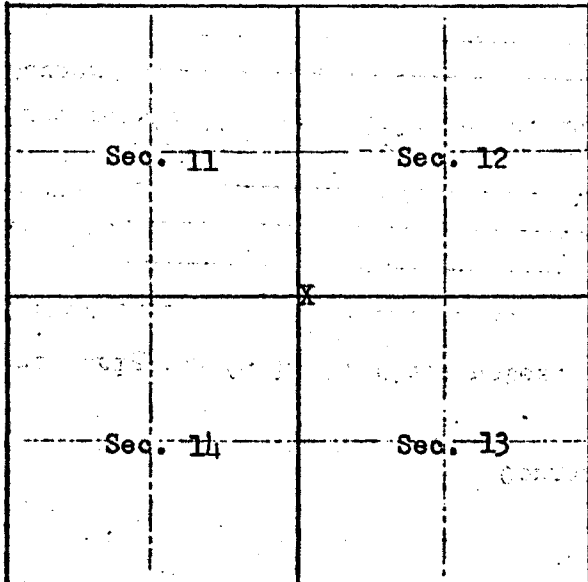

RETRACEMENT NOTES: Set a Cedar Post, from which:  
8" Cedar bears S. 71° W. 46 lks. No other trees within distance.  
Present Alex Wright & Geo. Tramel. I run from  $\frac{1}{4}$  Sec. Cor. between  
Sections 11 & 12 South to  $\frac{1}{2}$  Sec. Cr. between Secs. 13 & 14. Then begin  
at a large stone set by C. Sur., Collier, from  $\frac{1}{4}$  Sec. Cor. between Sec. 12 &  
13 and W. to  $\frac{1}{4}$  Sec. Cor. between Secs. 11 & 14.

\_\_\_\_\_  
Signature

December 1899

Date

Douglas County Surveyor's Office

Title

CS 53/1-70