

LANE COUNTY RESTORED CORNER

Index 2230

Corner $\frac{1}{4}$ Corner between Sections 23 and 26

Twp: 21 S R. 4 W

From original G. L. O. field notes, dated _____

EVIDENCE FOUND: _____, 19____

Corner _____

Witness _____

Marks _____


From reestablishment field notes, dated _____

EVIDENCE FOUND: _____, 19____

Corner _____

Witness _____

Marks _____

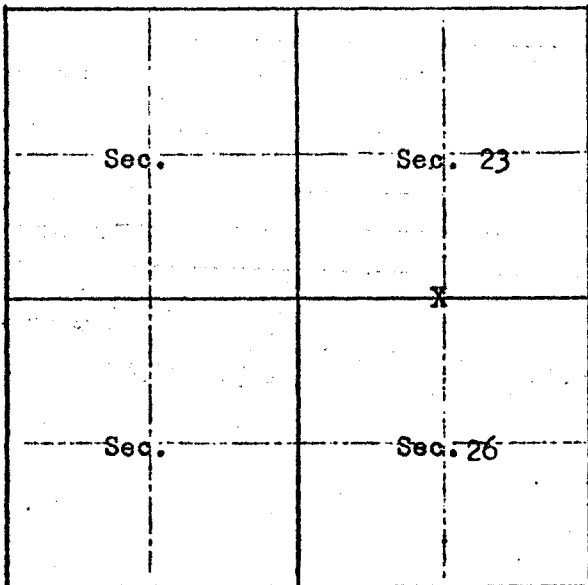

RETRACEMENT NOTES: Set a Stake 4" x 4" x 3' halfway between sections corners, from which: 14" D. Fir bears S. 12 $\frac{1}{2}$ ° E. 10.0 ft. mkd. $\frac{1}{4}$ S BT
No other trees available.

Gilbert A. Gardner

Signature

C.S. File No. 42/131 Map File M 2 - 16

(for Woodard Lbr. Co.)'s _____

December, 1955

Date

Title

Douglas County Surveyor's Office

CS 53/1-71