

LANE COUNTY RESTORED CORNER

Index 2231

Corner Section corner to Secs. 25, 26, 35, 36

Twp. 21 S R. 4 W

From original G. L. O. field notes, dated _____

EVIDENCE FOUND: _____, 19____

Corner _____

Witness _____

Marks _____


From reestablishment field notes, dated _____

EVIDENCE FOUND: _____, 19____

Corner _____

Witness _____

Marks _____

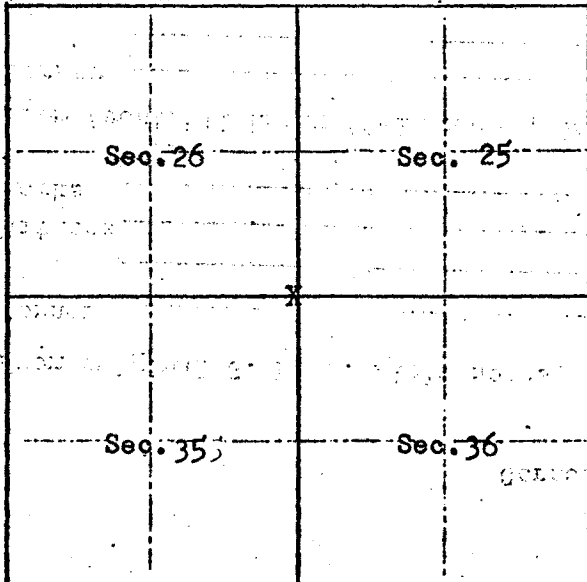

RETRACEMENT NOTES: Set at Proportionate distance.

Marked new BT's: 10" D. Fir S. 30° W. 13.8 ft. mkd. S 35 BT.

10" D. Fir S. 08° E. 29.2 ft. mkd. S 36 BT.

10" D. Fir S. 72° E. 13.9 ft. mkd S 25 BT.

10" D. Fir N. 62° W. 6.6 ft. mkd. S 26 BT.

Gilbert A. Gardner

Signature

December, 1955

Date

(for Woodard Lbr. Co.)

Title

Douglas County Surveyor's Office

C 53/1-72