

LANE COUNTY RESTORED CORNER

Index 2297

Corner North quarter corner Section 2

Twp. 21 S R. 4 W

From original G. L. O. field notes, dated 1854

Corner Post  
12" Fir North 10° East 42 links  
 Witness 12" Redwood South 29° East 30 links  
 Marks \_\_\_\_\_

EVIDENCE FOUND: February 20, 19 58

gone  
stump hole  
decayed wood-cedar

From reestablishment field notes, dated Aug. 29, 1900


Corner Old post gone. Fd. stump of R. Fir  
12" when marked bearing North 10° East 42 links  
 Witness fd. fallen trunk of old redwood  
 Marks Cedar set 8" fir North 17 $\frac{1}{2}$ ° West 38 links  
4" Fir South 30° East 29 links

EVIDENCE FOUND: February 20, 19 58

Fd: 17" Fir (standing) chopped out upper face and found scribing.  
21" stump chopped out and found scribing.  
~~Set Iron pipe and cedar post~~

RETRACEMENT NOTES: Set Iron pipe and cedar post  
Set by dist. and bearing from 1900 County Survey B.T.'s  
"W" nails, plates 20° declination

17" Fir North 17° West 24.4 feet C.S. B.T.  
10" Fir South 36° East 39.6 feet

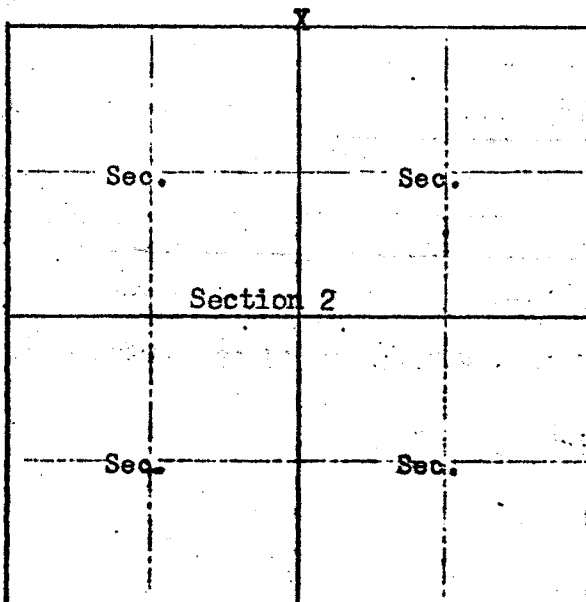

Glen McChesney

Signature

February 19, 1960

Date

Land Agent

Title

CS 53/1-74