

LANE COUNTY RESTORED CORNER

Index 2218

Corner  $\frac{1}{4}$  Section Corner Between Sections 5 and 6

Twp. 20 S R. <sup>10</sup> ~~12~~ W

From original G. L. O. field notes, dated \_\_\_\_\_ EVIDENCE FOUND: \_\_\_\_\_, 19\_\_\_\_

Corner \_\_\_\_\_

Witness \_\_\_\_\_

Marks \_\_\_\_\_

From reestablishment field notes, dated \_\_\_\_\_ EVIDENCE FOUND: \_\_\_\_\_, 19\_\_\_\_

Corner \_\_\_\_\_ (Set by H. L. Eppstein, Co. Surveyor, July 17, 1929)

Witness \_\_\_\_\_


Marks \_\_\_\_\_

RETRACEMENT NOTES: Set 4" X 36" Fir limb for Corner from Maple Witness Tree.

Marked new B.T.'s:

18" Maple N. 02° W. 68 feet

28" Fir S. 13° E. 25 feet.

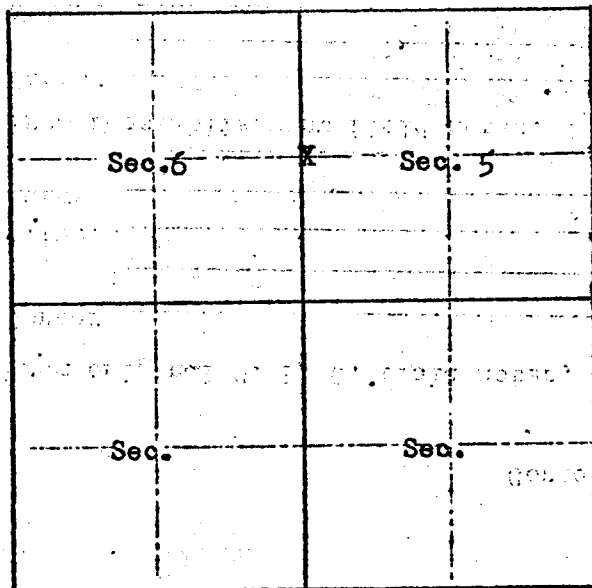

G. Robert Lecklider  
Signature

Map File M 8 - 38

February, 1958

Date

\_\_\_\_\_  
Title  
Douglas County Surveyor's Office

CS 53 / 1-76