

LANE COUNTY RESTORED CORNER

Index 1538

Corner Northeast Corner Section 36

Twp. 20 S R. 5 W

From original G. L. O. field notes, dated \_\_\_\_\_

EVIDENCE FOUND: \_\_\_\_\_, 19\_\_\_\_

Corner \_\_\_\_\_

Witness \_\_\_\_\_

Marks \_\_\_\_\_

From reestablishment field notes, dated \_\_\_\_\_

EVIDENCE FOUND: Stone- Nov. 28, 1958

Corner Stone

Corner: 18" x 10" Chiseled "T 20S R 5 W - S 36"

Witness \_\_\_\_\_

Marks \_\_\_\_\_


Restoration  
REPLACEMENT NOTES: 10" nails & plates

10" Oak N 13°W 83.6'

Telephone pole N 30°E 79.5'

Power pole S 74°E 98.2'

No reference to SW

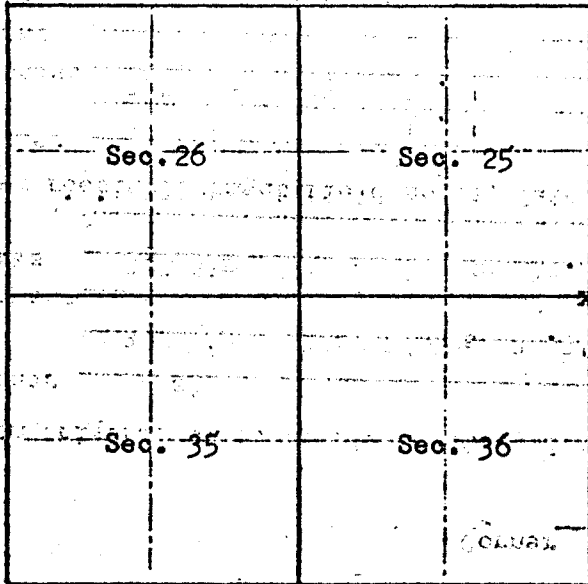

Glen McChesney  
Signature

EVIDENCE FOUND:

Dec. 17, 1958  
Date

Lend Agent  
Title

CS 53-11-83