

LANE COUNTY RESTORED CORNER

Index 1539

Corner East 1/4 Sec. Cor. Section 36

Twp. 20 S R. 5 W

From original G. L. O. field notes, dated 1854

EVIDENCE FOUND: Nov. 28, 1958

Corner Post

No trace.

30" Fir N 15°E 55 lks 36.3'

No trace.

Witness \_\_\_\_\_

Marks 30" Fir N 14°W 28 lks 18.5'

40" Fir - down broken rotted.

From <sup>C.S.</sup> reestablishment field notes, dated 1946

EVIDENCE FOUND: Nov. 28, 1958

Corner 18" Fir S 50°E 16.0'


Corner: Stake found in place.

Witness 18" Fir S 33°E 13.5'

18" Fir - faces - no scribing visible.

Marks \_\_\_\_\_

18" Fir " " " "

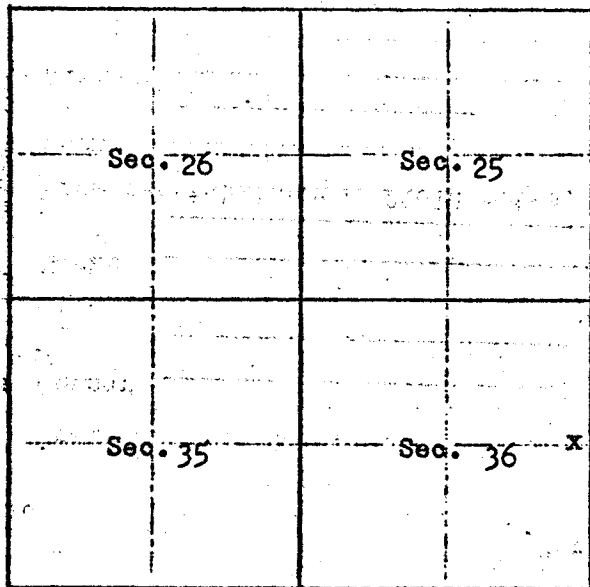

Restoration REESTABLISHMENT NOTES: \_\_\_\_\_

"W" nails & plates

18" Fir S 53°E 15.7'

18" Fir S 34°E 13.0'

Glen McChesney  
Signature

Dec. 17, 1958  
Date

Land Agent  
Title

CS 53/1-84

85-028-01