

#3 ✓

LANE COUNTY RESTORED CORNER

Index 2709

Corner Section - common to Sections 13, 14, 23, & 24

Twp. 19S R. 8W WM

From original G. L. O. field notes, dated Depend. Resurvey 1958

Corner US Cadastral Survey 2 1/2" iron pipe with brass cap from which a

Witness Cedar 20" diam. bears N 50E 33 1/2 lks.

Marks dist. mkd. T19S R 8W S 13 BT

~~From re-establishment field notes, dated~~ Cedar 13" diam. bears S 11E 33 lks. dist.

~~Corner~~ mkd. T19S R 8W S 24 BT

Witness Hemlock 13" diam. bears S 29 1/2 W 92 1/2 lks

Marks dist. mkd T 19S R 8W S 23 BT

Witness Fir 12" diam. bears N 42 W 57 lks dist.

Marks mkd T 19S R 8W S 14 BT

EVIDENCE FOUND: September 18, 19 61

Corner In place--iron pipe with brass cap from which a

Cedar 13" diam. bears S 11 E 3 lks dist. mkd

T 19S R 8W S 24 BT


~~EVIDENCE FOUND~~ Hemlock 13" diam. bears S 29 1/2 W 92 1/2 lks dist.

~~Corner~~ mkd T 19S R 8 W S 23 BT, 19

RETRACEMENT NOTES: Marked new bearing trees:

A maple 12" diam. bears N10E 91.5 feet mkd. CSBT

A fir 15" diam. bears N38 1/2 W 67.2 feet mkd. CSBT

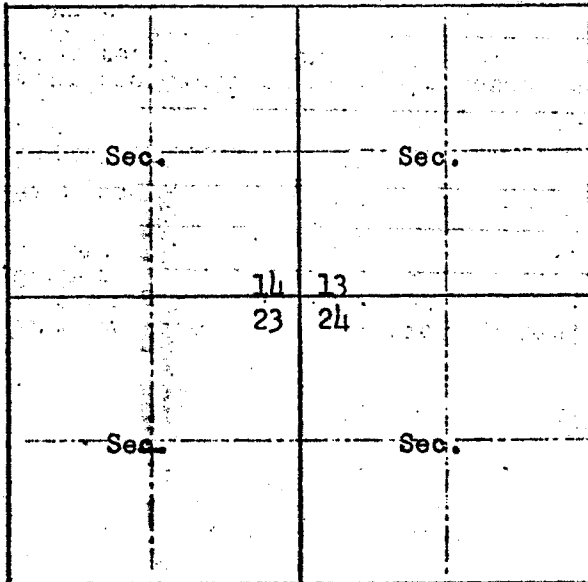

John Venator

Signature

Sept. 19, 1961

Date

Special Deputy Surveyor

Title

CS 53/1-91