

LANE COUNTY RESTORED CORNER

Index 1519

Corner Southeast Corner Section 18

Twp. 23 S R. 2 W

From original G. L. O. field notes, dated 1894

EVIDENCE FOUND: Nov. 6, 19 58

Corner Basalt Stone

Broken stone

36" Cedar N 22°E 121 lks 79.9'

Cedar snag - face burned out.

Witness 14" Hem. S 33°E 141 lks 29.0'

Evidence of Hemlock roots.

Marks 30" Hem. S 5°W 32 lks 21.1'

Large Hemlock rotted off close to ground level.

24" Hem. N 35°W 73 lks 48.2

Evidence of Hemlock roots.


From reestablishment field notes, dated \_\_\_\_\_

EVIDENCE FOUND: \_\_\_\_\_, 19 \_\_\_\_\_

Corner \_\_\_\_\_

Witness \_\_\_\_\_

Marks \_\_\_\_\_

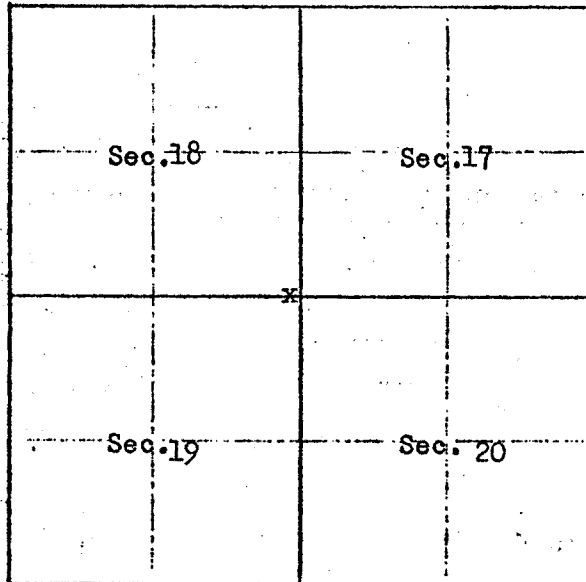

Restoration REESTABLISHMENT NOTES: Set 3/4" x 42" Monel Pipe & 3" Cedar Post.

Set on basis of the N 22°E B.T. & S 5°W B.T.

Set "W" nails, plates & brass disc.

12" Fir S 69°E 34.0'

13" Fir N 33°W 68.5'

11" Fir S 4°W 24.4'

10" Fir N 60°E 57.0'

M.D. Hale  
Signature

Nov. 21, 1958  
Date

Surveyor  
Title

T235-122W

85-028-01

- Outside the County -

CS 53/1-92