

LANE COUNTY RESTORED CORNER

Index 2145

Corner Northeast Corner Section 20

Twp. 23 S R. 2 W

From original G. L. O. field notes, dated 1894

EVIDENCE FOUND: 8/7, 1959

Corner Post

Gone

30" hem N31°E 46 lks

Rotten stump, no scribing

Witness 26" hem S66°E 55 lks

rotten stump, no scribing

Marks 16" hem S23°W 48 lks

No evidence found

8" cedar N43°W 41 lks

Face decayed, but some scribing vis.

From reestablishment field notes, dated \_\_\_\_\_

EVIDENCE FOUND: \_\_\_\_\_, 19\_\_\_\_

Corner \_\_\_\_\_

Witness \_\_\_\_\_

Marks \_\_\_\_\_

RETRACEMENT NOTES: Set 2" diam. cedar pole stake


Plates & "W" nails 20° Decl.

5" fir S8°W 11.9'

10" fir N27°W 60.6'

46" fir S68°W 5.7'

12" hem N79°E 10.5'

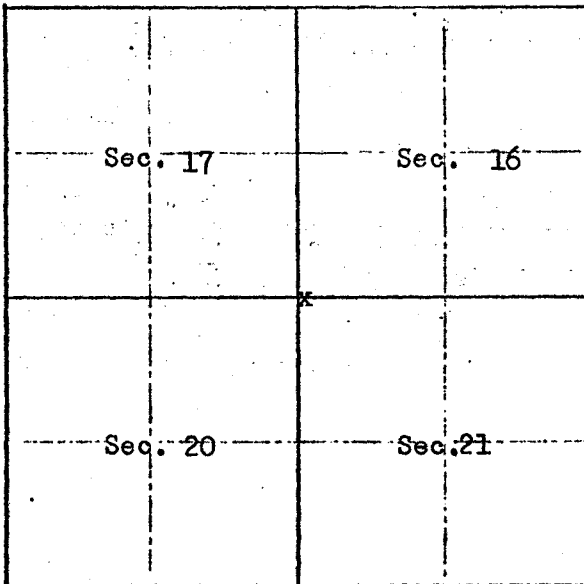

M. D. Hale

Signature

9/3/59

Date

Surveyor, WTCO.

Title

CS 5311-93