

LANE COUNTY RESTORED CORNER

Index 2530

Corner East one-quarter corner Section 20

Twp. 23 S R. 2 WEST

From original G. L. O. field notes, dated 1894

EVIDENCE FOUND: September 20, 1960

Corner Post

Gone

Witness 6" Fir North 80° East 27 links

Face not opened 16" Fir

Marks 18" Fir South 31° West 28 links

Scribing visible 22" Fir

From reestablishment field notes, dated _____

EVIDENCE FOUND: _____, 19____

Corner _____

Witness _____


Marks _____

RETRACEMENT NOTES: Found Brass Cap set in 1960.

Plates, "W" nails, 20° Declination

16" Fir North 81° East 16.8 feet

22" Fir South 32° West 16.9 feet

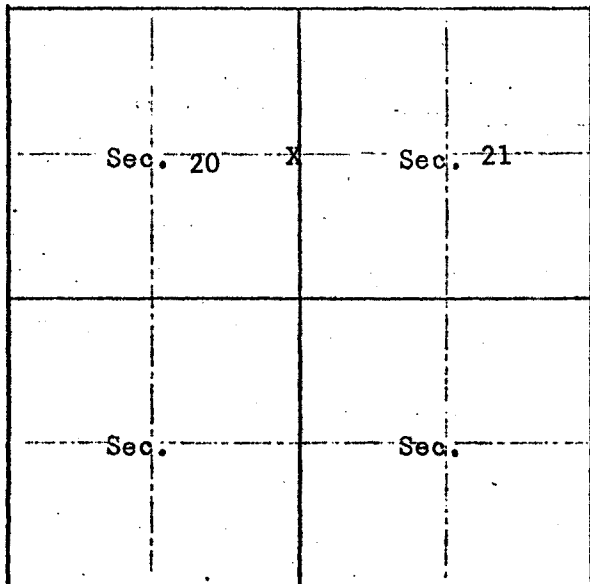

Glen McChesney

Signature

Oct. 12, 1960

Date

Land Agent

Title

CS 53/1-94