

LANE COUNTY RESTORED CORNER

Index 2532

Corner Northeast corner Section 22

Twp. 23 S R. 2 WEST

From original G. L. O. field notes, dated 1894

Corner Stone
26" Fir North 77° East 69 links
 Witness 30" Fir South 34° East 34 links
 Marks 20" Fir South 24° West 48 links
24" Fir North 10° West 20 links

From reestablishment field notes, dated 1960


Corner Brass Cap
12" Yew South 53° West 37.6 feet
 Witness 10" Maple North 85° West 48.8 feet
 Marks _____

EVIDENCE FOUND: August 25, 1960

Found mound of stone
38" Fir - scribing visible
36" Fir = scribing visible
18" fir Healed face
36" rotted fir stump no scribing visible

EVIDENCE FOUND: _____, 19____

Scribed and Plate
Scribed and Plate

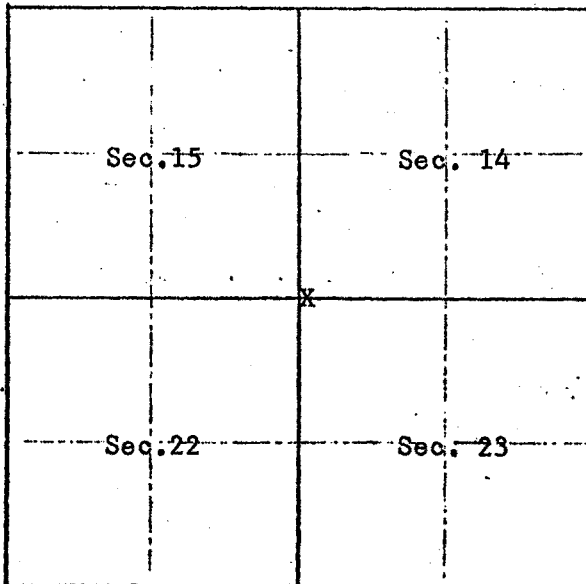

RETRACEMENT NOTES: _____

Plates, "W" nails, Declination 18½°

38" Fir North 76° East 40.4 feet Orig. B.T.
36" Fir South 38° East 20.5 feet Orig. B.T.
12" Yew South 53° West 37.6 feet
48" Fir North 70° West 21.8 feet

Glen McChesney
 Signature

Oct. 12, 1960
 Date

Land agent
 Title

CS 53/1-95