

LANE COUNTY RESTORED CORNER

Index 2660

Corner East one-quarter corner Section 22

Twp. 23 S R. 2 WEST

From original G. L. O. field notes, dated 1894

EVIDENCE FOUND: March 10, 1961

Corner Hemlock Post

Gone

12" Hemlock South 70° East 3 links

18" Hemlock snag down, and slid down hill-scrib visible

Witness _____

Marks 6" Hemlock North 12° West 14 links

no trace

From reestablishment field notes, dated 1960 GLO


EVIDENCE FOUND: March 10, 1961

Corner Brass Cap

Found Brass Cap

Witness 12" x 6' Hemlock stump North 86½° East 35 links

Marks 9" Hemlock South 28 3/4° West 30 links

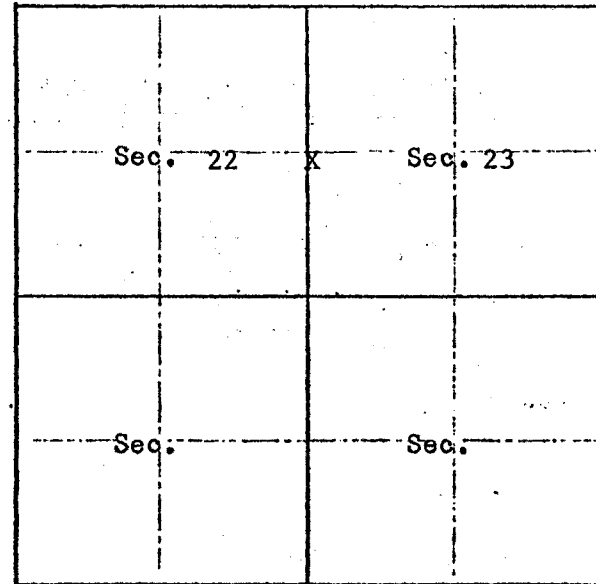

RETRACEMENT NOTES:

Plates, "W" nails - 20° Declination

68" Fir stump South 20° West 8.9 feet

50" Fir South 78° East 66.7 feet

Glen McChesney

Signature

4/20/61

Date

Land Agent

Title

CS 53/1-96