

LANE COUNTY RESTORED CORNER

Index 2698

Corner Southeast corner Section 22

Twp. 23 S R. 2 WEST

From original G. L. O. field notes, dated 1960

EVIDENCE FOUND: November 7, 1960

Corner Brass Cap

O.K.

20" Cedar North 19° East 28 links

Old face chopped out

Witness 10" Hemlock South 63° East 27 links

face partially grown over

Marks 18" Hemlock South 85° West 39 links

face partial grown over

10" Hemlock North 60° West 53 links

Destroyed by windfall timber

From reestablishment field notes, dated \_\_\_\_\_

EVIDENCE FOUND: \_\_\_\_\_, 19\_\_\_\_

Corner \_\_\_\_\_

Witness \_\_\_\_\_

Marks \_\_\_\_\_

RETRACEMENT NOTES: \_\_\_\_\_


Plates, "W" nails 20° Declination

34" Cedar North 21° East 17.7 feet

56" Fir South 74° East 20.3 feet

52" Fir South 47° West 27.1 feet

52" Fir North 22° West 46.7 feet

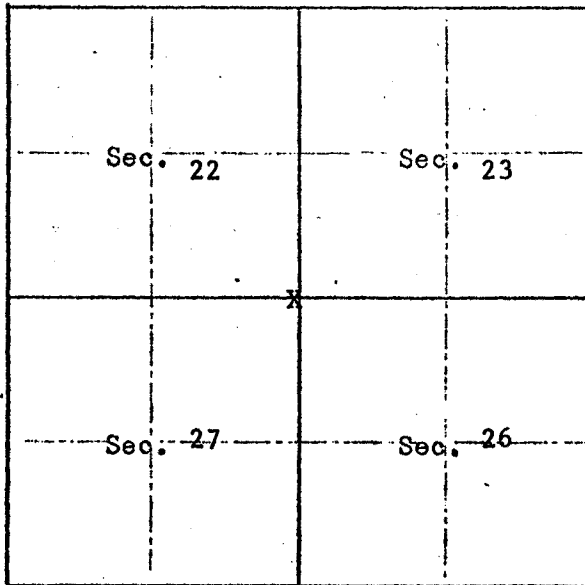

M. D. Hale

Signature

4/26/61

Date

Surveyor

Title

CS 53/1-97