

LANE COUNTY RESTORED CORNER

Index 2637

Corner North one-quarter corner Section 28

Twp. 23 S R. 2 WEST

From original G. L. O. field notes, dated 1894

Corner Stone

Witness 6" Hemlock South 34° West 27 links

Marks 7" Cedar South 21° East 32 links

From reestablishment field notes, dated _____

Corner _____

Witness _____

Marks _____

EVIDENCE FOUND: Feb. 6, 19 61

Found

Gone

Remains of down 12" Cedar but in S.W. instead of S.E. quadrant.


EVIDENCE FOUND: _____, 19 _____

RETRACEMENT NOTES:

Set 1" x 30" Alum. pipe on North side of stone. Plates, "W" nails, 20° Declination

60" Fir North 44° East 7.4 feet Brass disc

38" Fir South 11° East 38.0 feet Brass disc.

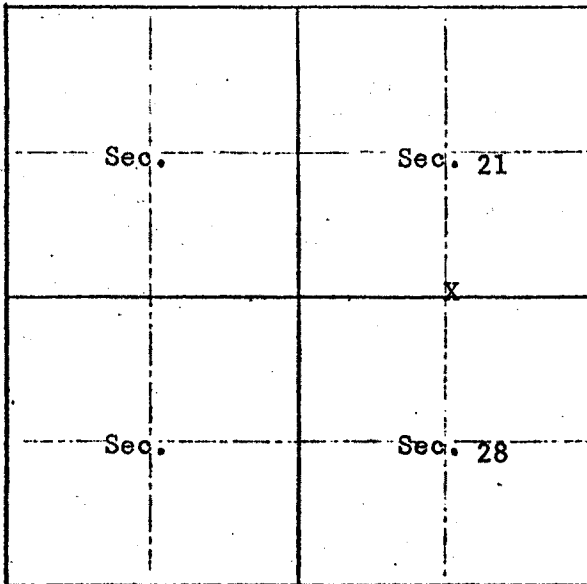

Glen McChesney

Signature

2/27/61

Date

Land Agent

Title

CS 53/1-98