


# PUBLIC LAND CORNERS

Index: 1219

WEYERHAEUSER TIMBER COMPANY  
SPRINGFIELD BRANCH

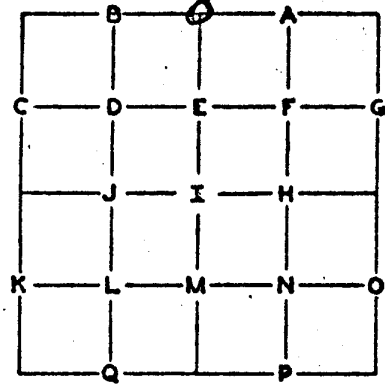

TOWNSHIP 20 S RANGE 11 W  
SECTION 35 CORNER NE  
COUNTY LANE OREGON

<b>GLO SURVEY RECORD</b> DATE: <u>1854</u> CORNER <u>Post</u>	<b>PRESENT CONDITION - (DESCRIBE FULLY - USE PAGE 2 IF NEEDED FOR EXPLANATION.)</b> No Trace																												
<b>ACCESSORIES:</b>																													
<table border="1" style="width: 100%; border-collapse: collapse;"> <thead> <tr> <th style="width: 15%;">BEARING-</th> <th style="width: 15%;">LINKS-</th> <th style="width: 15%;">FEET-</th> <th style="width: 55%;"></th> </tr> </thead> <tbody> <tr> <td>N 65° W</td> <td>20</td> <td>13.2</td> <td>28" P. St. Chopped out--found scribbling</td> </tr> <tr> <td>S 45° W</td> <td>30</td> <td>24.0</td> <td>5" P. St. Face scar, not chopped and for dist. &amp; bearing</td> </tr> <tr><td> </td><td> </td><td> </td><td> </td></tr> <tr><td> </td><td> </td><td> </td><td> </td></tr> <tr><td> </td><td> </td><td> </td><td> </td></tr> <tr><td> </td><td> </td><td> </td><td> </td></tr> </tbody> </table>	BEARING-	LINKS-	FEET-		N 65° W	20	13.2	28" P. St. Chopped out--found scribbling	S 45° W	30	24.0	5" P. St. Face scar, not chopped and for dist. & bearing																	
BEARING-	LINKS-	FEET-																											
N 65° W	20	13.2	28" P. St. Chopped out--found scribbling																										
S 45° W	30	24.0	5" P. St. Face scar, not chopped and for dist. & bearing																										
<b>SURVEY RECORD</b> DATE: _____	<b>PRESENT CONDITION:</b> _____																												

CORNER SET: 4 1/2 x 4 1/2" Yew Post MAGNETIC DECLINATION: ~~80X~~ <sup>X</sup> 20°

Found pointed cedar stake. Set by dist. and bear. from NW GLO EX BT

**BEARING AND DISTANCE TO ABOVE IDENTIFIED SURVEY ACCESSORIES:**

BEARING-	FEET-	SURVEY-	
65° W	13.2	GLO	
45° W	24.0	GLO	

CS 53 / 1-102

ACCESSORIES ADDED THIS DATE:

MAGNETIC DECLINATION

20°

	BEARING	FEET	ORIG. B.T.	"W" NAIL	PLATE	BRASS DISC
1st Pile	N 21° E	6.0		X	X	
2nd Pile	S 2° E	11.2		X	X	

IDENTIFIED ON PHOTO:

INFORMATION ON LOCATION OF CORNER AS NOW SET:

GROUND COVER: Thick reprod.

(USING FORM LINES SKETCH TOPOG AT CORNER ON PAGE 2 PLAT)

SLOPE FACES (GIVE BEARING IN DEGREES) S 45° W ON MINUS (-) 12 %

FROM CORNER -

NORTH: -2% old logging both sides line. Thick reprod.

SOUTH: -11% old logging to west, timbered to east. 1090' South to plate on post on north side county road.

EAST: +18% old logging to north, timbered to South

WEST: -15% old logging both sides of line.

WORK DONE FOR W. T. CO.:

FIELD NOTES IN BOOK:

BY: ENGINEER - SURVEYOR DATE: 2/1/58

ASSISTED BY: Robert Barta

UNDER THE SUPERVISION OF:

COPIES SENT TO:

SEAL

CS 53/f-102