

LANE COUNTY RESTORED CORNER

Index 1505

Corner South $\frac{1}{4}$ Corner Section 32

Twp. 20 S R. 1 W

From original G. L. O. field notes, dated 1854

EVIDENCE FOUND: Jan. 2, 1958

Corner Post

Gone

Witness 4" Fir N 65°E 8 lks 5.3'

Not Found.

Marks 30" " S 35°E 19 lks 12.5'

From reestablishment field notes, dated _____

EVIDENCE FOUND: _____, 19____


Corner _____

Witness _____

Marks _____

Restoration
RETRACEMENT NOTES: _____

~~After diligent searching and chopping I feel that this corner is lost.~~

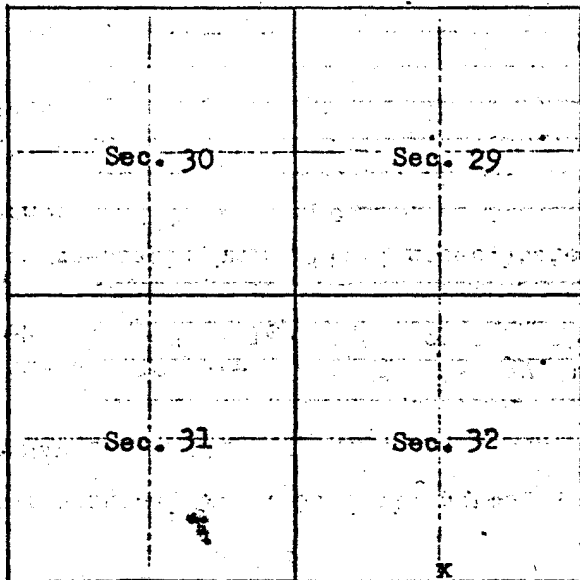

Douglas G. Calder
Signature

Jan. 22, 1959
Date

Engineer
Title

CS 5311-102