

LANE COUNTY RESTORED CORNER

Index 1515

Corner East $\frac{1}{4}$ Corner Section 31

Twp. 20 S R. 4 W

From original G. L. O. field notes, dated 1854

EVIDENCE FOUND: Dec. 26, 19 58

Corner Post

Gone

Witness 40" Hemlock N 32°E 10 lks 6.6'
12" Cedar S 60°W 29 lks 19.1'

Not found.

Marks _____


From reestablishment field notes, dated _____

EVIDENCE FOUND: _____, 19 _____

Corner _____

Witness _____

Marks _____

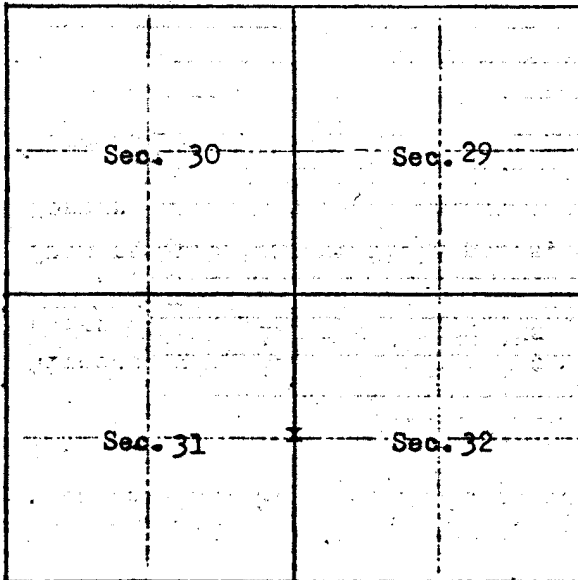

Restoration
RETRACEMENT NOTES:

After chaining the mile bet. Secs. 31 and 32 we found the corner to fall in the middle of an old R.R. grade. Also found angle bar (R.R.) which someone was using for the corner. We could find no record of its origin and no BTs. This point is too far North & West of where the cor. should be. So we destroyed this point.

Douglas G. Calder
Signature

Jan. 22, 1959
Date

Engineer
Title

CS 53/1-111