

LANE COUNTY RESTORED CORNER

Index 1516

Corner South  $\frac{1}{4}$  Corner Section 31

Twp. 20 S R. 4 W

From original G. L. O. field notes, dated 1854

EVIDENCE FOUND: Dec. 18, 19 58

Corner Post

Gone

30" Fir N 61°W 124 lks 81.8'

Found - standing and alive- bark scribed.

Witness \_\_\_\_\_

No Trace.

Marks 4" Fir S 7 $\frac{1}{2}$ °W 86 lks 56.8'


From reestablishment field notes, dated \_\_\_\_\_

EVIDENCE FOUND: \_\_\_\_\_, 19 \_\_\_\_\_

Corner \_\_\_\_\_

Witness \_\_\_\_\_

Marks \_\_\_\_\_

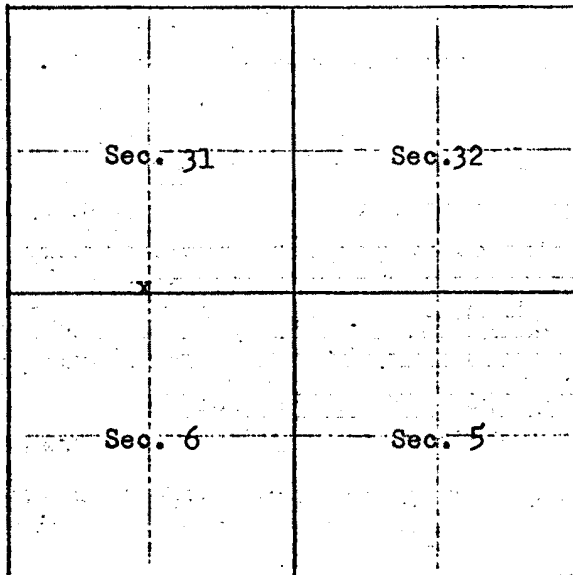

Restoration  
RETRACEMENT NOTES:

Found  $\frac{1}{2}$ " Iron Pipe at record bearing and distance from NW BT.

16" Fir N 18°E 13.3'

Engr. #4113

42" Fir S 36°W 51.8'

" "

Douglas G. Calder  
Signature

Jan. 22, 1959  
Date

Engineer  
Title

CS 53/1-112