

LANE COUNTY RESTORED CORNER

Index 1518

Corner North $\frac{1}{4}$ Corner Section 32

Twp. 20 S R. 4 W

From original G. L. O. field notes, dated 1854

EVIDENCE FOUND: Dec. 31, 19 58

Corner Post
8" Fir N 23°W 52 lks 34.3'

Gone
Down - Traces of Scribing visible on upper face & "BT"
after chopping out.

Witness _____
Marks 7" Fir S 23°E 8 lks 5.3'

Not found.


From reestablishment field notes, dated _____

EVIDENCE FOUND: _____, 19 _____

Corner _____

Witness _____

Marks _____

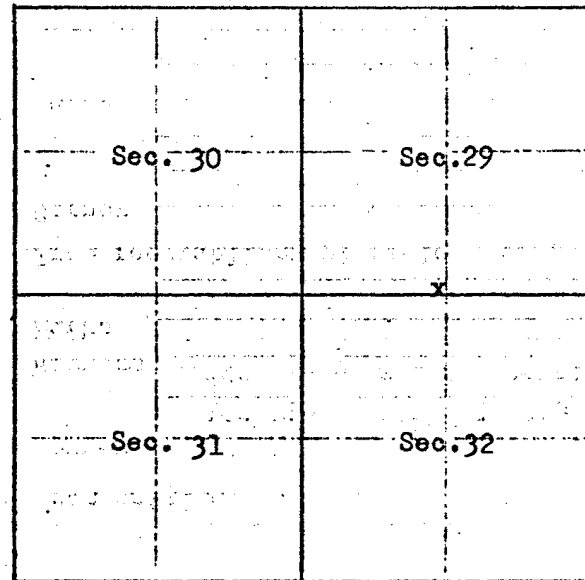

Restoration
RETRACEMENT NOTES: Fir Post $1\frac{1}{2}$ " X $1\frac{1}{2}$ " X 6' set by distance & bearing
from NW BT.

6" Fir N 13°W 21.4' Engr. #4113
10" Fir S 14°E 17.6' "

Douglas G. Calder
Signature

Jan. 21, 1959
Date

Engineer
Title

CS 531A-113