

LANE COUNTY RESTORED CORNER

Index 1524

Corner Northeast Corner of Section 32

Twp. 20 S R. 4 W

From original G. L. C. field notes, dated 1854

EVIDENCE FOUND: Dec. 12, 19 58

Corner Post \_\_\_\_\_

Gone

30" Fir N 38°E 28 lks 18.5'

Wind thrown - rotted and moved.

Witness 18" Fir S 80°E 28 lks 18.5'

24" Fir stub - chopped out- scribing visible.

Marks 24" Fir S 62°W 27 lks 17.8'

24" Fir stump - not chopped out.

30" Fir N 55°W 32 lks 21.1'

36" Fir stump - not chopped out.


From reestablishment field notes, dated \_\_\_\_\_

EVIDENCE FOUND: \_\_\_\_\_, 19 \_\_\_\_\_

Corner \_\_\_\_\_

Witness \_\_\_\_\_

Marks \_\_\_\_\_

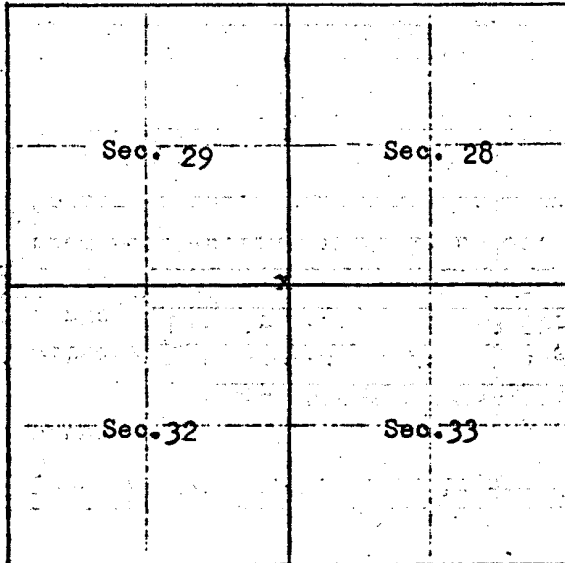

Restoration  
RETRACEMENT NOTES: Post 2" X 5' (fir) set cor. by distance from three  
standing BTs.

Plates "W" nails & Brass discs #1113

8" Fir N 24°E 22.3'

10" Fir South 27.0'

12" Fir N 8°W 17.5'

Douglas G. Calder  
Signature

Jan. 19, 1959  
Date

Engineer  
Title

CS 53/1-115

85-028-01