

LANE COUNTY RESTORED CORNER

Index 1525

Corner Southeast Corner Section 32

TWP. 20 S R. 4 W

From original G. L. O. field notes, dated 1851

EVIDENCE FOUND: Dec. 10, 19 58

Corner Post

Gone

50" Fir N 70°E 25 lks 16.5'

Stump - No axe marks & scribing.

Witness 12" Redwood S60°E 64 lks 42.2'

Down-scribing visible after chopping upper face.

Marks 10" Fir S58°W 83 lks 54.8'

15" stub. Two faces chopped out. No scribing.

18" Hem. N60°W 69 lks 45.4'

No trace.

From reestablishment field notes, dated _____

EVIDENCE FOUND: _____, 19 _____

Corner _____

Witness _____

Marks _____

Restoration

REPLACEMENT NOTES: 2" Fir Post set by record bearing and distance from

50" & 10" Fir BTs.


Plates "W" nails & Brass discs, #1113

6" Chinquapin N 24°E 22.1'

4" Fir S 79°E 47.9'

8" Fir S 57°W 47.2'

6" Fir N 54°W 28.9'

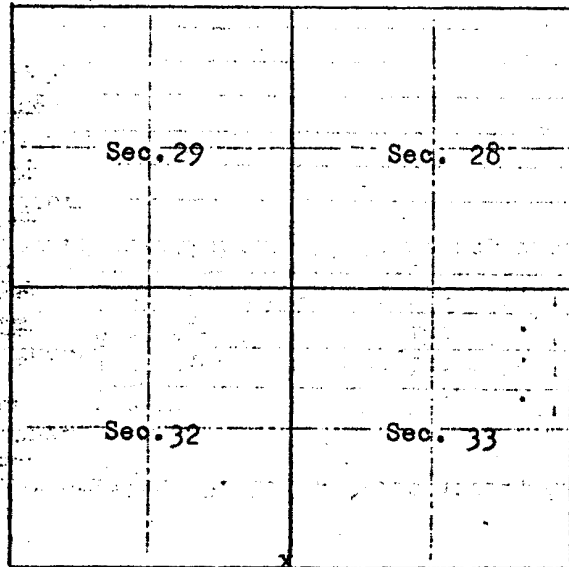

Douglas G. Calder
Signature

Jan. 19, 1959
Date

Engineer
Title

CS 53/1-116