

LANE COUNTY RESTORED CORNER

Index 1535

Corner Southwest Corner Section 32

Twp. 20 S R. 4 W

From original G. L. O. field notes, dated 1854

EVIDENCE FOUND: Dec. 2, 1958

Corner Post
18" Fir N 7°E 49 lks 32.3'
 Witness 12" Fir S 14°E 61 lks 40.2'
 Marks 20" Fir S 43°W 87 lks 57.4'
8" Fir N 60°W 96 lks 63.4'


Gone
24" Fir stub - scribing visible.
16" Fir stub - 2 faces - no scribing visible.
Remains of rotted stump.
No trace,

From ^{C.S.} reestablishment field notes, dated 1933

EVIDENCE FOUND: Dec. 2, 1958

Corner 9" Fir N 31½°E 68 lks 44.9'
10" Fir S 59°E 12 lks 7.9'
 Witness 9" Fir S 36°W 8 lks 5.3'
 Marks 12" Fir N 69°W 52 lks 34.3'

Destroyed by re-logging.
Trace of down - rotted fir.
Down rotted.
Destroyed by re-logging.

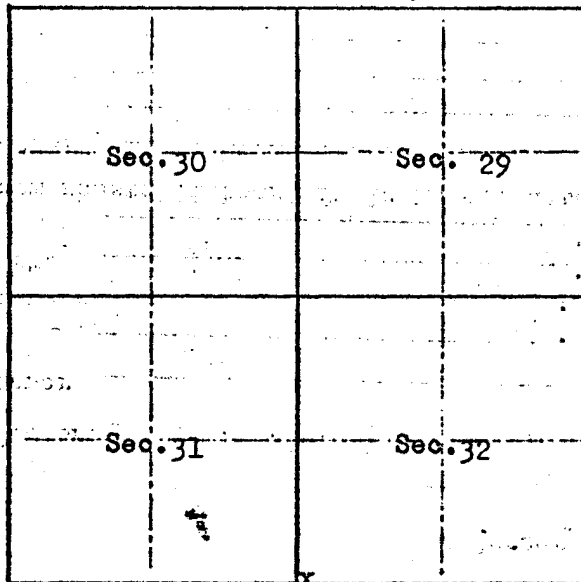

^{Restoration}
 REPLACEMENT NOTES: Found 2" Iron Pipe & scribed post.
"W" nails & plates.

10" Fir N 67°E 90.0'
10" Fir S 28°E 44.7'
10" Fir S 10°W 42.1'
18" Fir N 7°W 18.3'

Glen McChesney
 Signature

Dec. 17, 1958
 Date

Land Agent
 Title

CS 53/1-118

85-028-01