

LANE COUNTY RESTORED CORNER

Index 2519

Corner West quarter corner Section 34 Twp. 20 S R. 4 WEST

From original G. L. O. field notes, dated 1854

Corner Post
10" Redwood North 05° East 65 links

Witness
Marks 40" Fir North 75° West 27 links

From reestablishment field notes, dated _____

Corner _____

Witness _____


Marks _____

EVIDENCE FOUND: April 26, 19 60

Gone
Fd. 42" Fir stump badly decayed Brg. N 12° East dist O.K.

Fd. 11" R. Cedar down. Both faces badly burned. Fd. old
axe marks on lower edge of both faces

EVIDENCE FOUND: _____, 19 _____

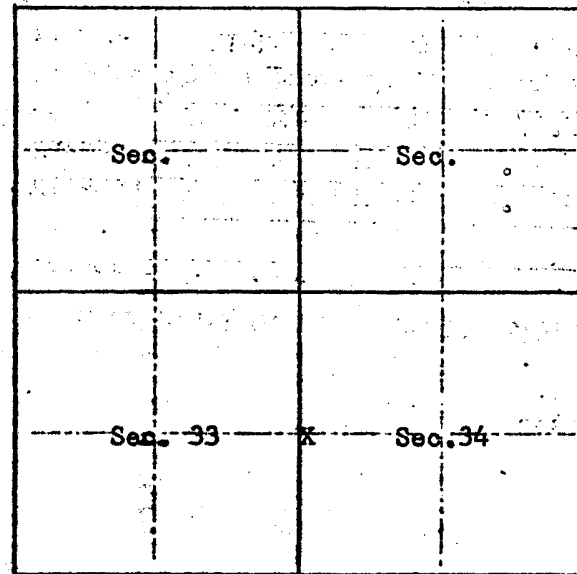

RETRACEMENT NOTES:

Set 1"x30" alum pipe Plates, "W" nails 20° Declination

10" Fir North 84° East 42.3 feet

14" Fir North 70° West 8.3 feet

Glen McChesney

Signature

6/9/60

Date

Land Agent

Title

CS53/1-119