

REN. T 245 R 4 W

C.C. S 1 / R 3
S 12 / W

AT CDR. FD. G.L.O. BRASS CAP,
DATED 1950

FD. 28" FIR N 31 1/2° W 25 1/2 FT. -
RECENT BLOWDOWN. - PORTIONS OF
SCRIBE MKS. VISIBLE IN NOT COMPLETELY
HEALED SCAR.

FD. 26" FIR S 54° 45' W 32 1/2 FT. -
RECENT BLOWDOWN - SCAR VISIBLE -
LYING FACE DOWN.

BLAZE & SCRIBE 2 NEW TREES:

13" DOUG FIR N 57° W 10 1/2 FT.

MKD. "T 245 R 4 W S 1 C C C S BT"

7" INCENSE CEDAR S 79° W 28 1/2 FT.

MKD. "C C S 12 C S BT"

FEB. 15, 1963

*Mil
C. Godfrey*

M.G.
Y.T.
M.S.

JUNE 18, 1963

13" FIR N 57° W 10 1/2 FT. IS NOW DOWN,

BLAZE & SCRIBE NEW TREE:


7" HEMLOCK N 57° W 70 1/2 FT.

MKD. "C C S 1 C S BT"

M. C. G.

to X

Section 1 - Top 24S. Box 4W W.M. Date: 1/17/63

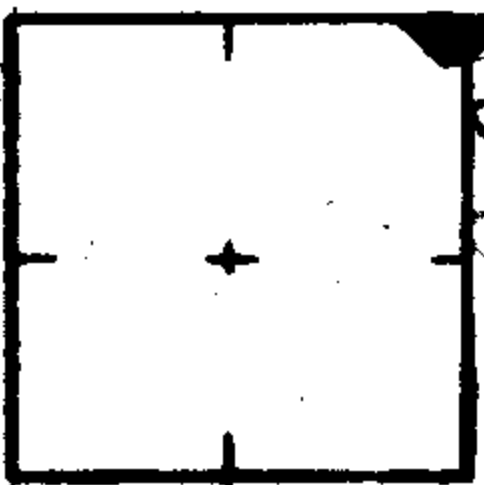

How was corner identified? Brass Cap

Condition of corner: Both bearing trees are down

Best route to reach corner:

REH... FEB 15 1963

Other Remarks:

Quadrant	NE	NW	SE	SW
Species & Size				
Dist. & Bearing				
Condition of Scribe				
Original of Resurvey				
Appearance of B.T.				
Tags, Marks, etc.				

H.C. B... Forester
BLM Signed
Resurvey Office