

REM. T 23 S R 4 W $\frac{1}{4}$ $\frac{S9}{S16}$

RE RENEWAL OF BOYER'S
RENEWAL OF $\frac{1}{4}$ COR.
FD. OLD SCRIBED WOODEN STAKE
IN FENCE COR. " $\frac{1}{4}$ S 9" ON N. SIDE - OTHER
SIDES BURNED
FIR STUMP (NOW 36" DIAM.)
BEARS S 71° E 44^c FT. GOOD SCRIBING
VISIBLE "B.T."

FD. 23" FIR SNAG N 20° E
42^B FT. (INSTEAD OF N 43° E). GOOD
SCRIBING VISIBLE " $\frac{1}{4}$ S BT" -
SCRIBED FACE DEFINITELY FACES FENCE
COR. & NOT DIRECTION AS CALLED
FOR IN NOTES. - SCRIBING APPEARS
SAME AGE AS SCRIBING ON STUMP
TO S.E.

A DEPRESSION IN GROUND - (POSSIBLE
STUMP HOLE) BEARS N 15° E 43 LKS. -
(FITS CALL FOR ORIG N.E. B.T.)

IN FENCE COR. (FENCES NORTH
& EAST) SET IRON PIPE WITH BRASS
CAP MKD. "COUNTY SURVEYOR'S OFFICE
1963 T 23 S R 4 W $\frac{1}{4}$ $\frac{S9}{S16}$ "

NO LIVE TREES WITHIN 500 FT.
OF COR.

FEB. 8, 1963

M. G.
V. T.
M. S.


Milo E. [Signature]

H. X. V

C.S. File No. 53/9-8

Section 9 TWP 235 Rge 4 W

Date: 1/28/63

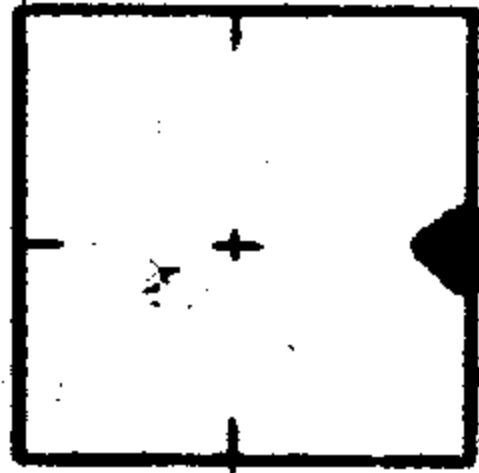

How was corner identified? Scribed wooden stake at

Fence corner

Renewal Condition of corner: Poor. Wind to the old

Fence corner

RENEWED 1963
BOYER 87 1963
FEB. 87 1963
Quiblo E. Godfrey
route to reach corner: Zakerstate #5 and Elkhead road.

Quadrant	NE	NW	SE	SW
Species & Size	DF 16"		DF 32"	
Dist. & Bearing	N 13° E 40' (approx)		S 66° E 35' (approx)	
Condition of Scribe	Fair		Fair	
Original or Resurvey	Orig (probably)		Orig. (probably)	
Appearance of B.T.	Fire killed snag		old stump	
Tags, Marks, etc.	Chopped out		Chopped out	

Other Remarks:

Both B.T.s will
soon be lost due
to decay.

Boyer 87 1963