

REN. T 23 S R 4 W

COR. SECS. 9/10
16/15

FD. FIR STUMP (NOW 42" DIAM.)

N 45° E 42 1/2 FT. CUT OPEN & FD.
GOOD SCRIBING "B"

FD. HOLLOW MAPLE S 24° W

19 1/2 FT. - PORTION OF OLD ROTTEN
FACE INSIDE WITH GOOD SCRIBING
"T 2 R 4 W S 16" VISIBLE ON OLD
FACE,

NO TRACE OF N.W. OR S.E. TREES
FD.

AT COR. SET IRON PIPE WITH
BRASS CAP MKD. "COUNTY SURVEYOR'S
OFFICE 1963 T 23 S R 4 W S 9 | S 10"
S 16 | S 15

BLAZE & SCRIBE NEW TREES:

12" INCENSE CEDAR N 10° E 111 1/2 FT.

MKD. "T 23 S R 4 W S 10 CS BT"

17" INCENSE CEDAR N 25° W 92 1/2 FT.

MKD. "T 23 S R 4 W S 9 CS BT"

12" WHITE FIR S 52° W 44 1/2 FT.

MKD. "T 23 S R 4 W S 16 CS BT"

NO TREES AVAILABLE TO S.E.

COR. IS IN FENCE COR. - FENCES
NORTH, SOUTH, & WEST FROM COR. -
SCRIBED STAKE IS 1 FT. SOUTH.

FEB. 8, 1963

M.G.

V.T.

M.S. 53/99


+X✓✓

THE NO.

Section 9 Twp 23 S Rge 4 W N

Date: 1/28/63

How was corner identified? Scribed wooden stake

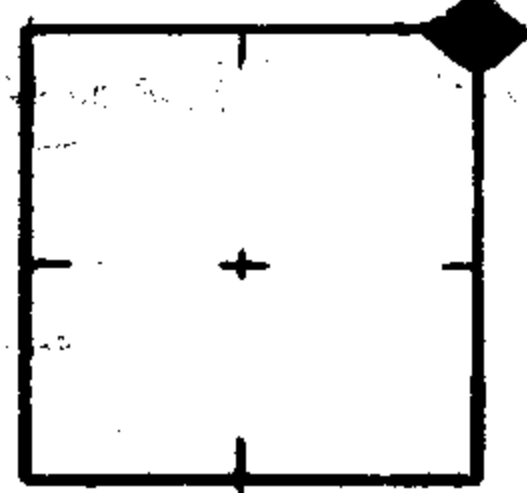

Condition of corner: Fair at present but should be brass capped

Best route to reach corner: Interstate #5 and Elkhead road.

RENEWED 8/19/63
FED: 8/19/63
Mable

Other Remarks:
Scribing visible inside old
fire scar on tree. Is
rapidly rotting out so
is imperative that it
be replaced. Tree in NW
quad. marked to be saved
For New B.T. Survey
Wm J. Rice

Quadrant	NE	NW	SE	SW
Species & Size				Bigleaf maple 16" H
Dist. & Bearing				S 24° W 20' approx
Condition of Scribe				Good
Original or Resurvey				Orig. probably Poor
Appearance of B.T.				Yellow tag
Tags, Marks, etc.				