

REN. T 23 S R 6 4 & 5 W $\frac{1}{4}$ S 1 S
24 19

AT COR. FD. $1\frac{1}{4}$ " IRON PIPE,

FD. FIR (UPROOTED & PARTLY ROTTED)

N 20° W 26 $\frac{1}{2}$ FT. - CUT OPEN & FD

GOOD SCRIBING " $\frac{1}{4}$ "

FD. LAUREL SPROUTS - (WITH ROTTEN
LAUREL LOG LYING ON GROUND) S 35° E

6 $\frac{1}{2}$ FT. - DID NOT LOOK FOR SCRIBING

IN LAUREL.

IRON PIPE IN GOOD CONDITION. -

DID NOT SET NEW MONUMENT,

BLAZE & SCRIBE NEW TREES:

8" DOUGLAS FIR S 60° W 13 $\frac{3}{4}$ FT.

MKD. " $\frac{1}{4}$ S 24 CS BT"

9" YEW TREE N 12° E 85 $\frac{1}{2}$ FT.

MKD. " $\frac{1}{4}$ S 19 CS BT"

APR. 25, 1963

M. G.

M. S.


Milo C. Coffey

C. S. File No.

~~53/9-122~~

+ X O ✓
O ✓

Section 19 TWP 23 S Rge 4 Date: 4/22/63

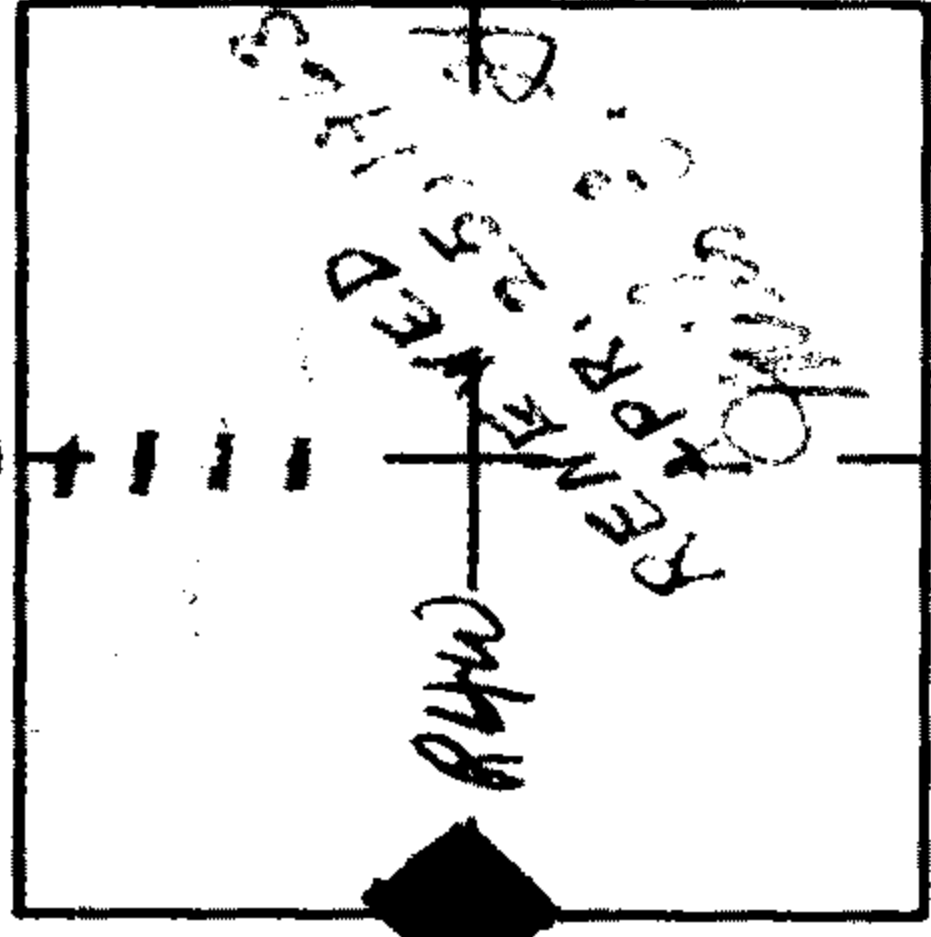

How was corner identified? Iron pipe and old 4x4 scribed wooden stake

Condition of corner: Wooden stake rotting away and only part of scribe legible

Best route to reach corner: Take stake #5 past Rice Hill then road thru sec. 14, 23 & 24 on 4565sqrd that goes up Red Hill.

	NB	NW	SE	SW
Quadrant				
Species & Size				
Dist. & Bearing				
Condition of Scribe				
Original or Resurvey				
Appearance of B.T.				
Tags, Marks, etc.				

Other Remarks: No B.T.'s found. Is a old corner area. One downed tree has a Haines tag on it.

John G. Rice
Signed