

MST, WESTERLY

RENEW SW COR, DLC 49

T305 R5W

FD AXLE SHAFT AT COR.
AND BT AS RECORDED #128
SCRIBED FACE OF BT IS NOW
PARTLY ROTTED.

REScribe 46" B.OAK

N58 E W 43.5 SW DLC 49

CS BT.

+X✓

RENEW NW COR DLC 52


T305 R5W COR #18

FOUND - TRUCK SPRING AT
COR 6" UNDER SURFACE, AND
BOTH BTS AS RECORDED BY B.B.I.

WE REScribe EACH BT.

NW DLC 52 CS BT.

FENCE COR THUS

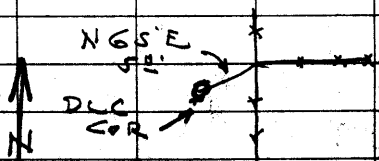

+X✓
M.D.

SEPT 26-53

CS 53/26-2