

RENEW $\frac{1}{4}$ COR 17/16 T30S R5W


FOUND—

UNAG OF ORIG. NE BT

WE ALSO FIND BOTH BTS AS
RECORDED BY MARKHAM 1955
110 EXCEPT 40' B.D. SHOULD
BE N 20° E. 65' NOT N 25° E
AND S 87° W NOT N 87° W. WE
DO NOT FIND $\frac{1}{2}$ " I.P. SET AT
CORNER. SEE C.S. 49/38

SET BRASS CAP AT COR
MND. COUNTY SURVEYORS OFFICE
1963 $\frac{1}{4}$ S 17/16 T30S R5W

FENCE COR. THUS

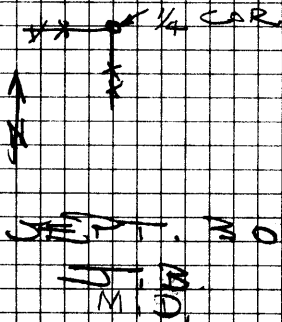

SET BY MND. CO. 1963