


RENEW SW COR - D.C. 37

T30S R5W

FOUND - 3/4" I.P. AT COR 2"
UNDER SURFACE. WE ALSO FOUND
2" NOW 60" BLOCK THAT CHECKS
BEARING & DIST. FOR COR. # 81.
NOTE 2" RA (SHOWS GOOD SCARS)

FENCE COR TRUS.

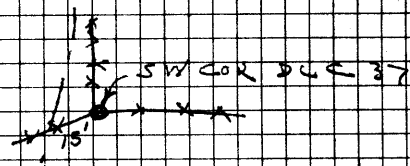

STREAM #

SET BRASS COR ALONGSIDE COR
I.P. # MARK COUNTY SURVEYORS
OFFICE 1963 SW D.C. 37

T30S R5W

NEW BIT
R. FIR BEARS N 88° E 52.5'
SCRIBED SW D.C. 37 C.S.B.T.

12' MAPLE BEARS S 52° E 45'
SCRIBED SW C. 37 C.S.B.T.

DIETZGEN NO. 385-6