


RENEW $\frac{615}{718}$ T 30 S R 5 W

FOUND - $1\frac{1}{4}$ I.P. 3" UNDER SURFACE. WE DO NOT FIND AXLE SET BY FREAR # 40.

SEE MIDWAY TRACTS FOR LOC. OF THIS COR.

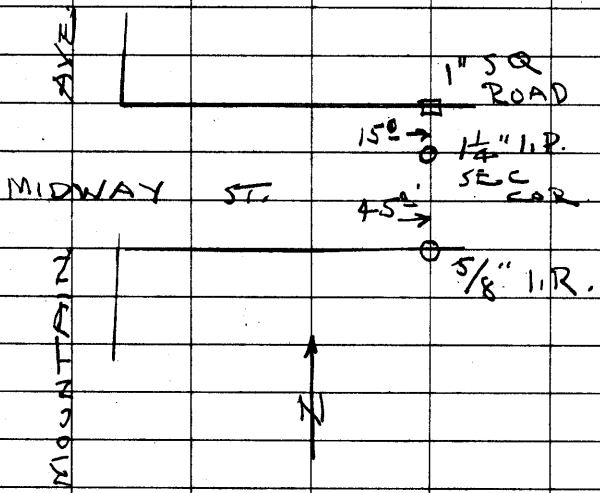

NO TREES NEAR

FILED RECEIVED

OCT 21 1963

COUNTY SURVEYOR
CLATSOP COUNTY, ORE.

$$\begin{array}{r} 2 \\ 57 \\ 49.6 \\ \hline 106.6 \end{array}$$

CS 53/26 -19