


RENEW $\frac{1}{4}$ COR. $\frac{18}{19}$ T 30S RSW

FOUND - 1" I.P. AT COR & UNDER
E.W. FENCE, & NOW 20" I.P.
S 0°30' W 7.6 SHOWS SCRIBING
ON OLD FACE. WE DO NOT
FIND ANY TRACE OF ORIG.
BTS. - ~~BE~~ BURNEL C.S. 39/171

WE FIND BTS FOR ANOTHER COR.
THUS

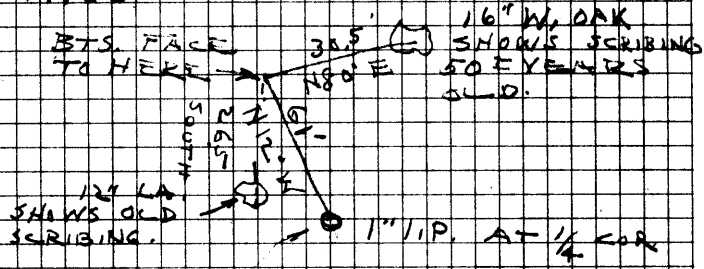

NEW BIT
5" W. OAK BEARS N 29° E
SCRIBED $\frac{1}{4}$ S 18° AS BIT
(SCRIBED HIGH)

OCT. 18 - 1963

~~11~~
~~11~~
~~11~~

+XO

DIETZEN NO. 385-6