


TIE TO BTS. FROM WEST 1/4
COR 518 T305 R5W

FO
AXLE - COR. #13
AT

1/4 COR. BTS OK.

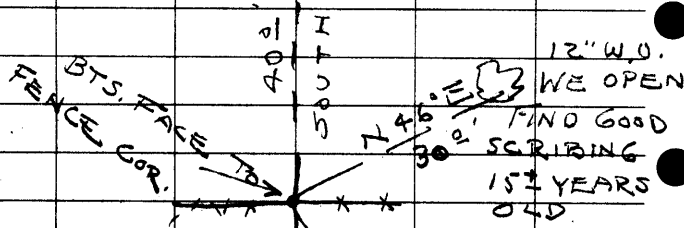

12" W.O.
WE OPEN
FIND GOOD
SCRIBING
15+ YEARS
OLD

FOUND O.K.

10" W.O. OAK
SHOWS GOOD
SCARS

FILED
RECEIVED

OCT 18 1963

COUNTY SURVEYOR
DOUGLAS COUNTY, ORE.

CS 53/26-27