

RENEW $\frac{1}{4}$ COR. 6/5 T30S R4W

FOUND - 1" I. PIPE AT COR. #


ORIG. 36" NOW 42" LAUREL NGS' W

NOT N 25° W 15.8' WE ALSO FIND

NOW 38" B. OAK N 25° E 660 NOT

N 45° W 649' Rem. # 75

FENCE COR. TAUS

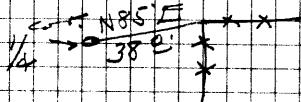

NEW B.T.S

9" R. I. FTR N 19° E 27.8'

SCRIBED $\frac{1}{4}$ S T C S B T

RESCRIBE ORIG. NOW 42" LAUREL

NGS' W 170' $\frac{1}{4}$ S 6 C S B T

DIETZEN NO. 385-6

FILED

RECEIVED

AUG 12 1963

COUNTY SURVEYOR
DOUGLAS COUNTY, ORE.

○ Rem. # 75

+ * ✓

C. S. File No. 53/26-54