

RENEW $\frac{1}{4}$ COR $\frac{10}{15}$ T 305 R4W
FOUND -


BOTH ORIG. BTS. ORIG.

20" NOW 26" W. OAK N78 $\frac{1}{4}$ W 363'
SHOWS SCRIBE MARKS, 15' NOW
30" B. OAK S19° W 41'
SHOWS GOOD SCAR.

1 PIPE SET BY STEWART
NOT FOUND. WE DO FIND
BASE OF OLD STAKE AT COR.
SET BRASS CAP AT CORNER
MAD. COUNTY SURVEYORS OFFICE
1963 $\frac{1}{4}$ S10 T305 R4W
 $\frac{5}{15}$

RESCRIBE. NOW 30" B. OAK
S19° W 42 $\frac{3}{4}$ " $\frac{1}{4}$ S15 CSBT.

FENCE COR. THUS.

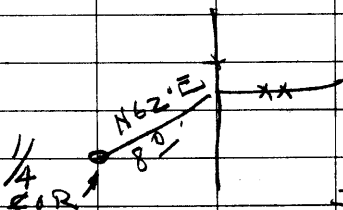

JUNE 11-63

VAR 200

J. B.
M. D.
B. S.

♀ X ✓

CS53/26-57