

RENEW <sup>29 19</sup> 28 38 T-305

R5W R4W

FOUND - STONE AT ~~THE~~ ALL BITS,  
AS RECORDED ALL ARE NOW  
SNAGS


SET 3/4" I.R. BOUNDBSIDE COR.  
STONE.

NEW ST. . .

15" FIR BEARS N5°W 12.5'

SCRIBED T-305 R5W S 24' C&BT

FENCE COR. THIS  
NO OTHER TREES NEAR

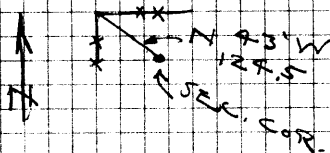

M.I.D.  
B.S.

OK J.W.B.

FILED  
RECEIVED

JUL 29 1963

COUNTY SURVEYOR  
DOUGLAS COUNTY, ORE.

*Handwritten signature/initials*

C. S. File No. 53/26-78

DIETZGEN NO. 385-6