

RENEW $\frac{1}{4}$ COR 1A T30S R4W
30


FOUND - 1" I.P. IN MOUND OF
STONE. AT CORNER, FIND STUMPS
OF ALL B.T.S. CUT LOW NO
SCRIBING FOUND. ORIG. NE BT
NOW BURNED SNAG SHOWS BURNED
FACE

NEW B.T.S.

6" MAPLE BEARS S25°W 69.7
SCRIBED $\frac{1}{4}$ S30CSBT

12" FIR BEARS N22°W 69.8
SCRIBED $\frac{1}{4}$ S19CSBT

NOTE - OLD FENCE COR. THIS

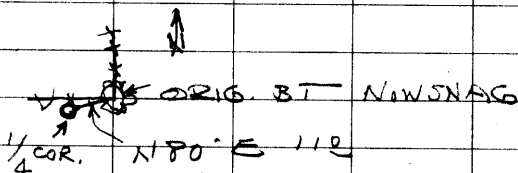

JULY 27-63

J.B.

M.D.

B.S.

+ * O^v
re-renew

CS 53/26-79