

RENEW SW COR DLC #1

T30 S 24° E V

FOUND - BOTH BTJ AS RECORDED

BY FREAT 919. 12" Nawi 33°


W. OAK N 37²⁵ E 38.9' SHOWS

GOOD SCAR. 16" Nawi 24° E V. OAK

N 16¹² E 61.7' SHOWS GOOD SCAR

WE DO NOT FIND I.P. SET
AT CAR.

FENCE COR. THIS

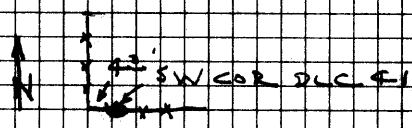

WE SET 3/4" I.P. AT CAR

DIETZEN NO. 388-G

FILED

RECEIVED

AUG 26 1968

COUNTY SURVEYOR
DOUGLAS COUNTY, ORE.

+ X #110

C. S. File No. 53/26 24'