

RENEW SE COR. DLC 47 T30S

RAW


FOUND - 14" NW 20" W. OAK

S 73° E 2239' WE OPEN & FIND
GOOD SCRIBING "47". WE DO NOT
FIND 1 BAR AT CORNER.

NOTE: COR. FALLS ON HGV ROAD
ASPHALT SURFACE. METAL FINDER
DOES NOT OPERATE PROPERLY ON
ROAD SURFACE IN THIS AREA.

WE MEASURE DIST. FROM SW
COR DLC 48 1259.3' WHICH IS AS
SHOWN BY STEWART'S 1922 SURVEY
CHECKS OK.

SET 3/4" IR. FLUSH AT COR. THIS

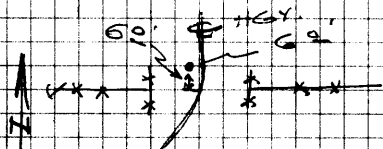

NEW BTB.

20" R. FIR BEARS S 74° E 1933'

SCRIBED SW DLC 47 CS BT

DESCRIBE 20" W. OAK S 73° E 2239'

SE DLC 47 CS BT.

+X O

C. S. File No. 53/26-106

DIETZEN NO. 385-6