


FOUND CORNER
REVIEW / CAP 15 T305 R4-V
22

FOUND - 3/4" I.P. IN MOUND OF
STONES @ 28" MAPLE N.W. E. 5/1
ALL AS RECORDED BY THOMPSON
FENCE COR THOS.

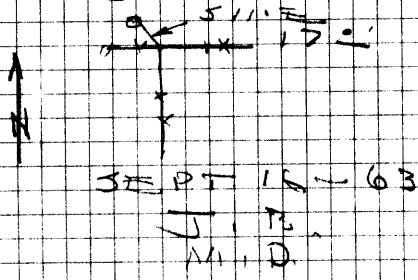

SEPT 15 - 63
U. S.
M. D.

FILED
RECEIVED

SEP 17 1963

COUNTY SURVEYOR
DOUGLAS COUNTY, ORE.

DIETZGEN NO. 385-6

+X ✓

C. S. File No. 53/26-109