

REN.

T 27 S R 4 W

C.C.

24

SECS

25

(ON W. LINE T 27 S R 3 W)

AT COR. FD. BRASS CAP SET
IN 1917 SURVEY. - STILL FIRMLY SET.
FD. FIR TREE (NOW 38" DIAM.)


S $31\frac{3}{4}^{\circ}$ W 310 FT. - VERY PLAIN AXE
SCAR VISIBLE. - TREE ALIVE & IN
GOOD CONDITION.

FD. DEAD & ROTTING FIR SNAK
N 65° W 475 FT. - SHOWS GOOD
SCAR.

BLAZE & SCRIBE ONE NEW TREE:

40" DOUG. FIR N $77\frac{1}{2}^{\circ}$ W 67⁸ FT.

MKD. "T 27 S R 4 W C.C. S 24 CS BT"

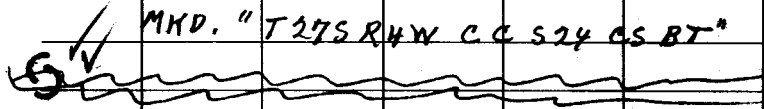

FD. O.K. W. $\frac{1}{4}$ ^S 19 T 27 S R 3 W

BRASS CAP & BOTH B.T.'S

MKD. IN 1917 IN GOOD CONDITION.

OCT. 9, 1963

Milo E. Duffey

M.G.

W.S.

M.D.

J.H.

+X