

REN. T27SR4W

CDR. 14/13
SECS. 29

FD. ROCK SET IN 1917 - IN PLACE.

FD. BOTH FIR STUMPS MKD. IN 1917:

32" FIR STUMP S60°W 16⁰ FT

(GOOD SCAR)

36" FIR STUMP N51°W 7² FT.

(GOOD SCAR)

ALSO FD. BOTH TREES MKD. BY US
IN 1959:

20" CEDAR N3°W 43² FT. -

SCRIBING STILL VISIBLE.

30" FIR S86°W 27⁰ FT. -

SCRIBING STILL VISIBLE.

ALONGSIDE ROCK AT COR. SET
IRON PIPE WITH BRASS CAP MKD.
"COUNTY SURVEYOR'S OFFICE 1963

T27SR4W S14/S13"
S23

DID NOT MARK NEW TREES.

JAN. 2, 1963

Wils. C. Godfrey

M.G.


V.T.

M.S.

Section 23 Twp 27S Rge 4W

Date: 12/13/67

How was corner identified? Bearing trees

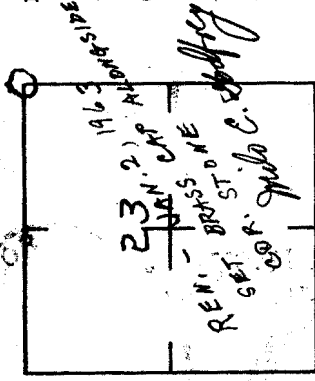

Condition of corner: Not Found. Might be

old stake painted red

Best route to reach corner: County road then up

Fox Creek to Winzel Fox horns then east
up hill

Other Remarks:

| Quadrant | NE | NW | SE | SW |
|----------------------|----|----------------------|----|--------------------|
| Species & Size | | <u>I Cedar 14"</u> | | <u>D. F. 24"</u> |
| Dist. & Bearing | | <u>425' S. 30° E</u> | | <u>27' N 86° E</u> |
| Condition of Scribe | | <u>Good</u> | | <u>Good</u> |
| Original or Resurvey | | <u>Orig.</u> | | <u>Orig.</u> |
| Appearance of B.T. | | <u>Good</u> | | <u>Good</u> |
| Tags, Marks, etc. | | <u>Tag</u> | | <u>Tag</u> |

Signed _____
PAGE - 38