

515/514

Review Sec Cor, 522/523 T275 R4W

Fd. 1959 C.S. BRASS Cap firmly set & MKd. "515/514 522/523 T245 R7W" we change

Tps. & Rgs. To "T275 R4W". All BTs alive & in good cond. See Ren #54.

The NE. BTs will be Removed, Leaving -

39" B. OAK S, 89° E. 135 1/2 ft

Shows scribe on unhealed blaze.

We MK. New BT.


30" B. OAK N, 7° W, 252 1/2 ft

Mkd. "T275 R4W 515 CS BT"

No other suitable Trees within 300 ft of cor. - This cor lies on Hillside sloping West approx. 75 ft. E of Road.

August 23, 1967

U.R.T.
J.H.
D.W.

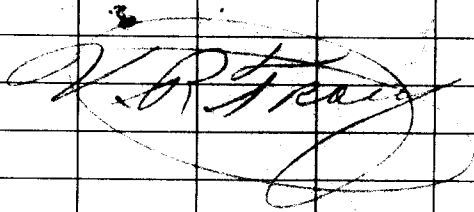

OH30 OK. J.W.B.

C.S. File No. 53/33-52