



T 27 S R 4 W

CORNERS FD. O.K.

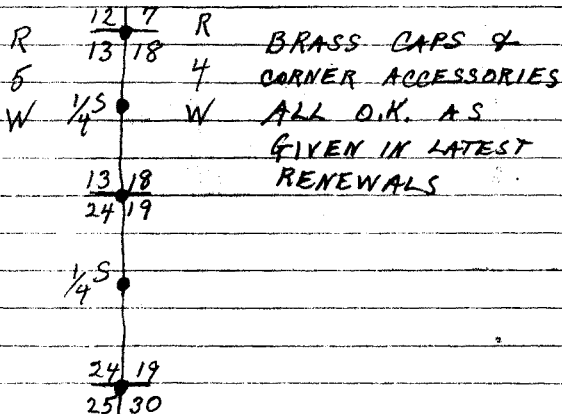

CORNERS NOT FD.

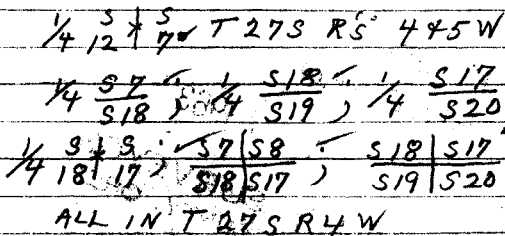

Paul E. Jeffrey

OCT. 7, 1963

M.G.
W.S.
M.S.
J.H.